


AS BUILT

ROMTEC UTILITIES EQUIPMENT LAYOUT

1	BOOSTER SKID 1
2	BOOSTER SKID 2
3	BOOSTER SKID 3
4	FUTURE BOOSTER SKID 4
5	SUCTION CONNECTION ASSEMBLY
6	DISCHARGE CONNECTION ASSEMBLY 1" ARV/TAPPING SADDLE (INSTALLATION LOCATION IS BY OTHERS)

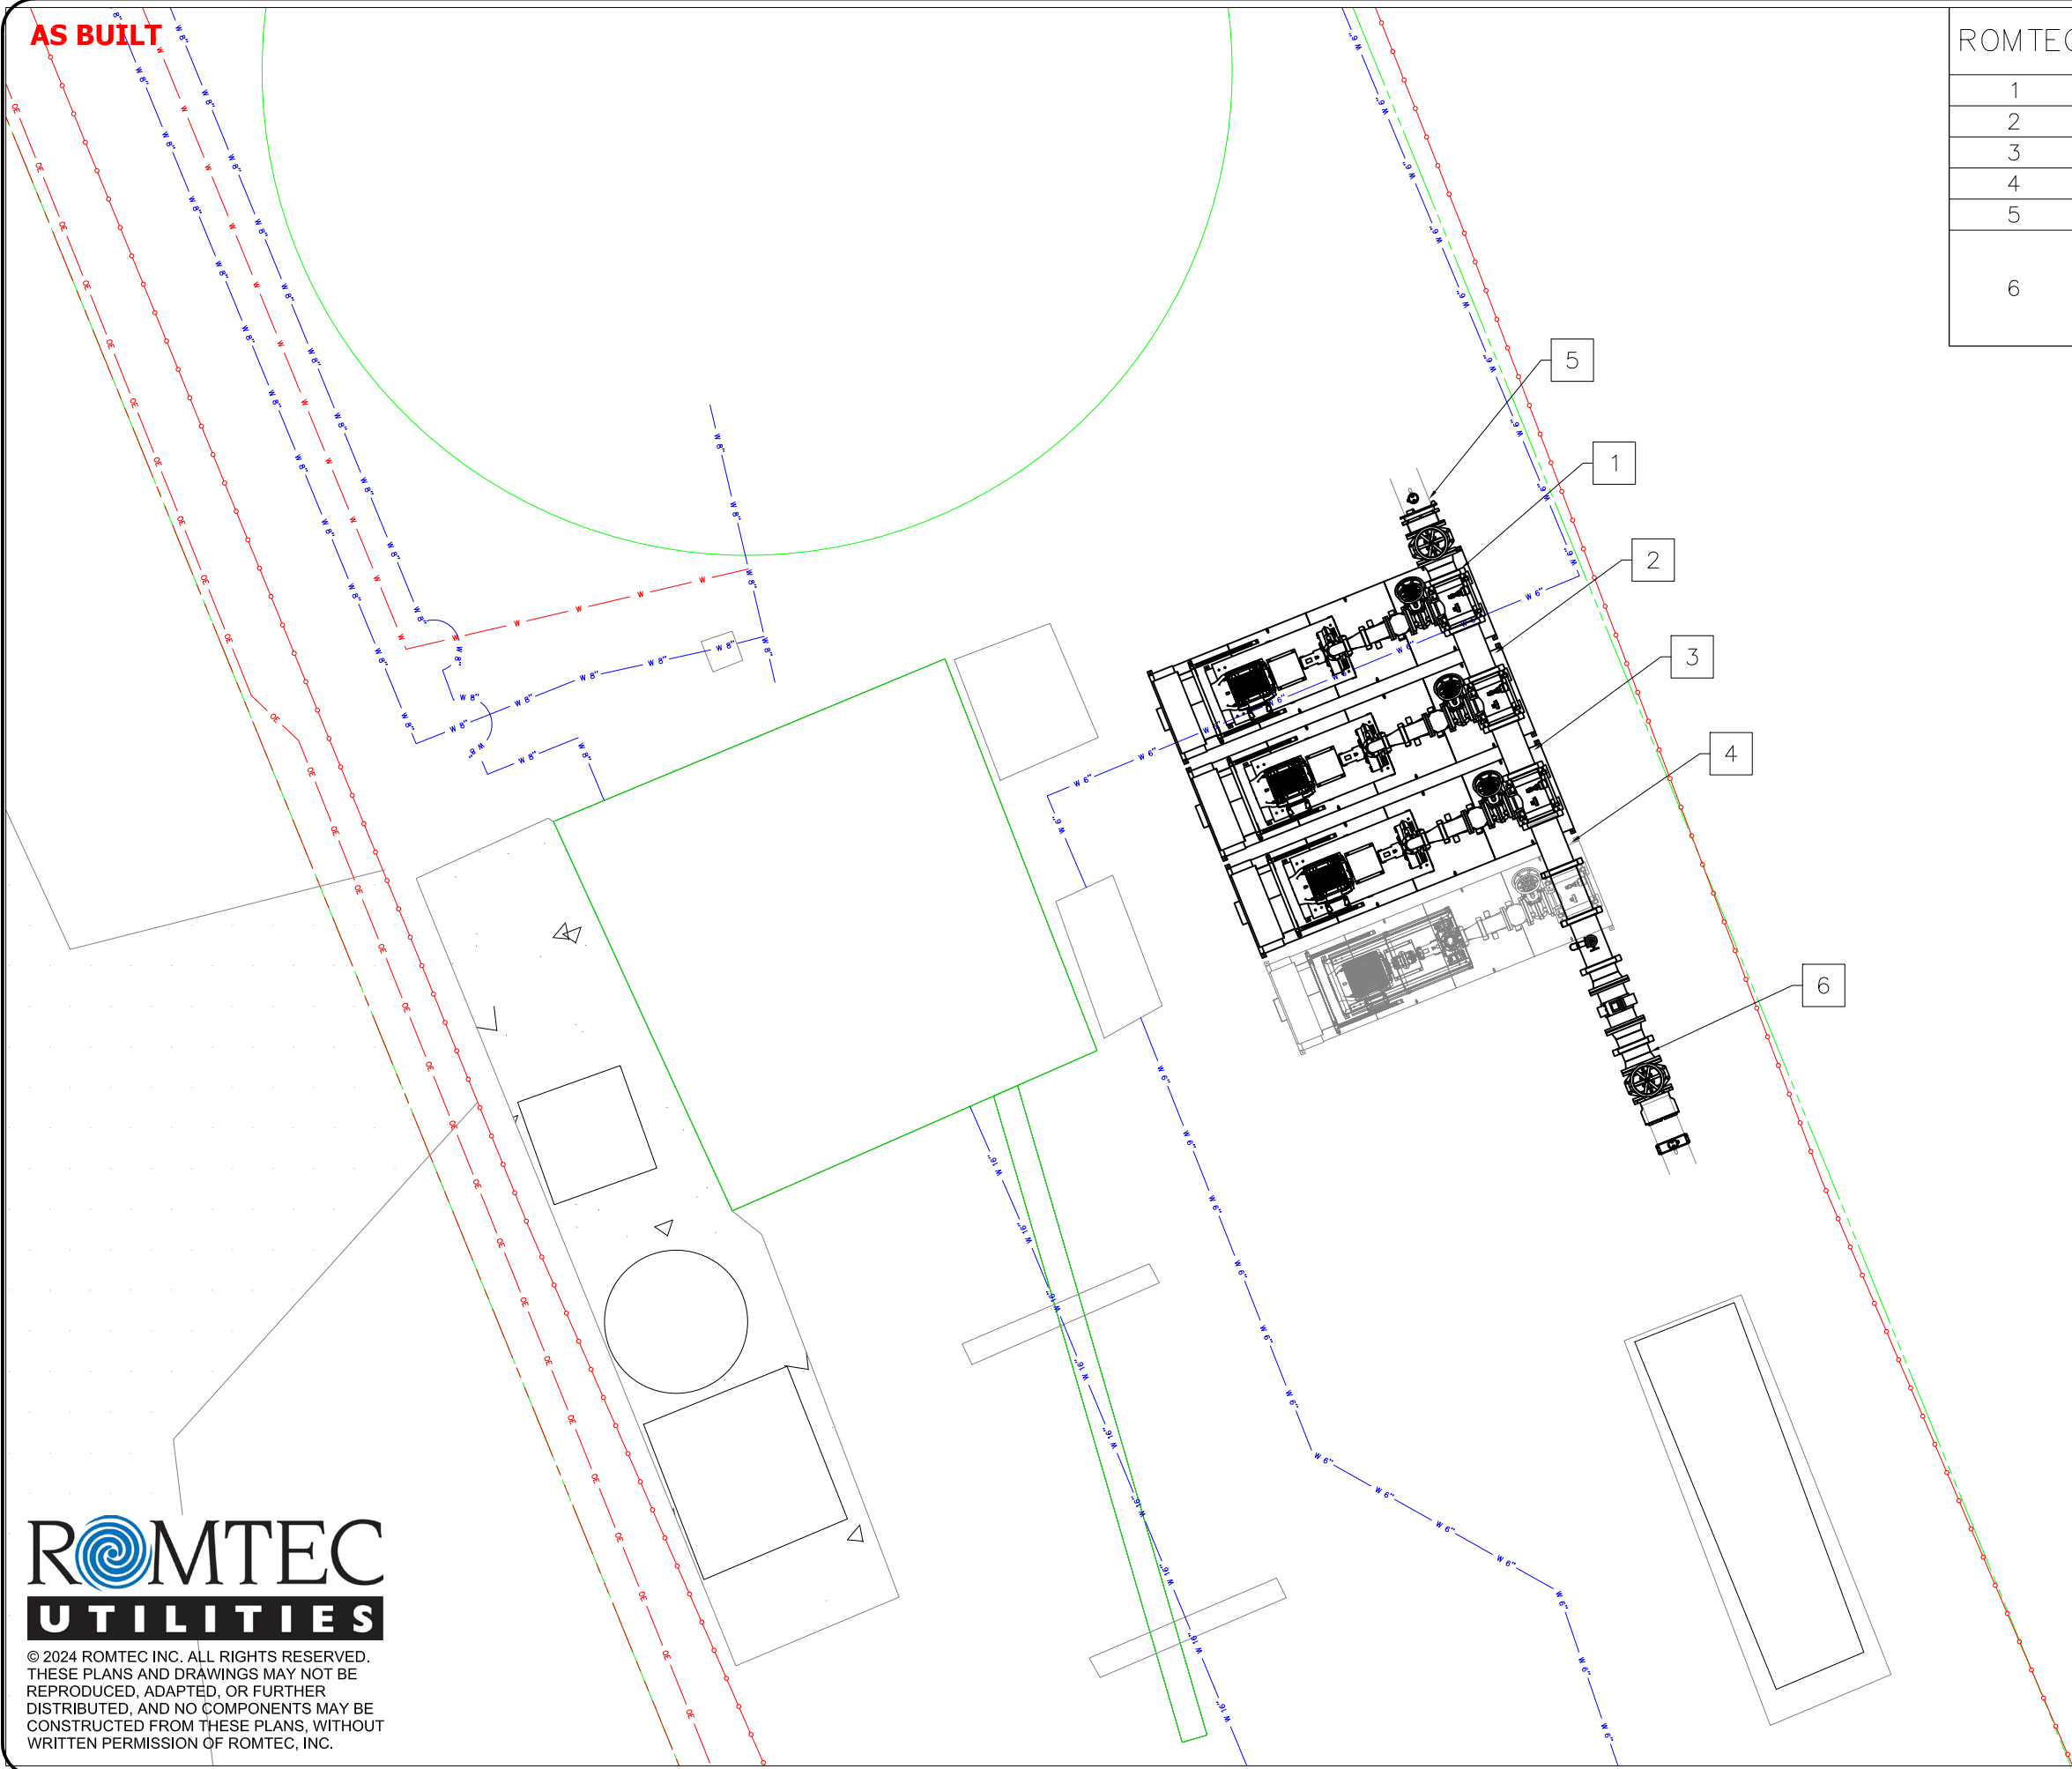

CC	ADDED SKID FOUNDATION
3	6/04/24
2	4/17/24
1	4/10/24
REV	DATE

VERIFY SCALE
 0 1"

 DSN: KB
 DRN: KB
 CKD:
 DATE: 3-13-24

ROMTEC UTILITIES
 18240 NORTH BANK ROAD
 ROSEBURG, OREGON 97470
 PHONE: (541) 496-9678
 WWW.ROMTECUTILITIES.COM

WELL 6 BPS UPGRADE
 VAN ALSTYNE, TX
 BOOSTER PUMP STATION
 LAYOUT DRAWING

SHEET
 C-01



© 2024 ROMTEC INC. ALL RIGHTS RESERVED. THESE PLANS AND DRAWINGS MAY NOT BE REPRODUCED, ADAPTED, OR FURTHER DISTRIBUTED, AND NO COMPONENTS MAY BE CONSTRUCTED FROM THESE PLANS, WITHOUT WRITTEN PERMISSION OF ROMTEC, INC.



NOTE: ALL DIMENSIONS AND ELEVATIONS SHOWN ARE NOMINAL DIMENSIONS. IT IS THE RESPONSIBILITY OF THE ON-SITE CONTRACTOR OR ROMTEC UTILITIES CUSTOMER (NOT ROMTEC UTILITIES) TO VERIFY THE ACCURACY OF ANY CRITICAL DIMENSIONS OR ELEVATIONS PRIOR TO SETTING OR INSTALLING ANY EQUIPMENT.

AS BUILT