


FRONT VIEW

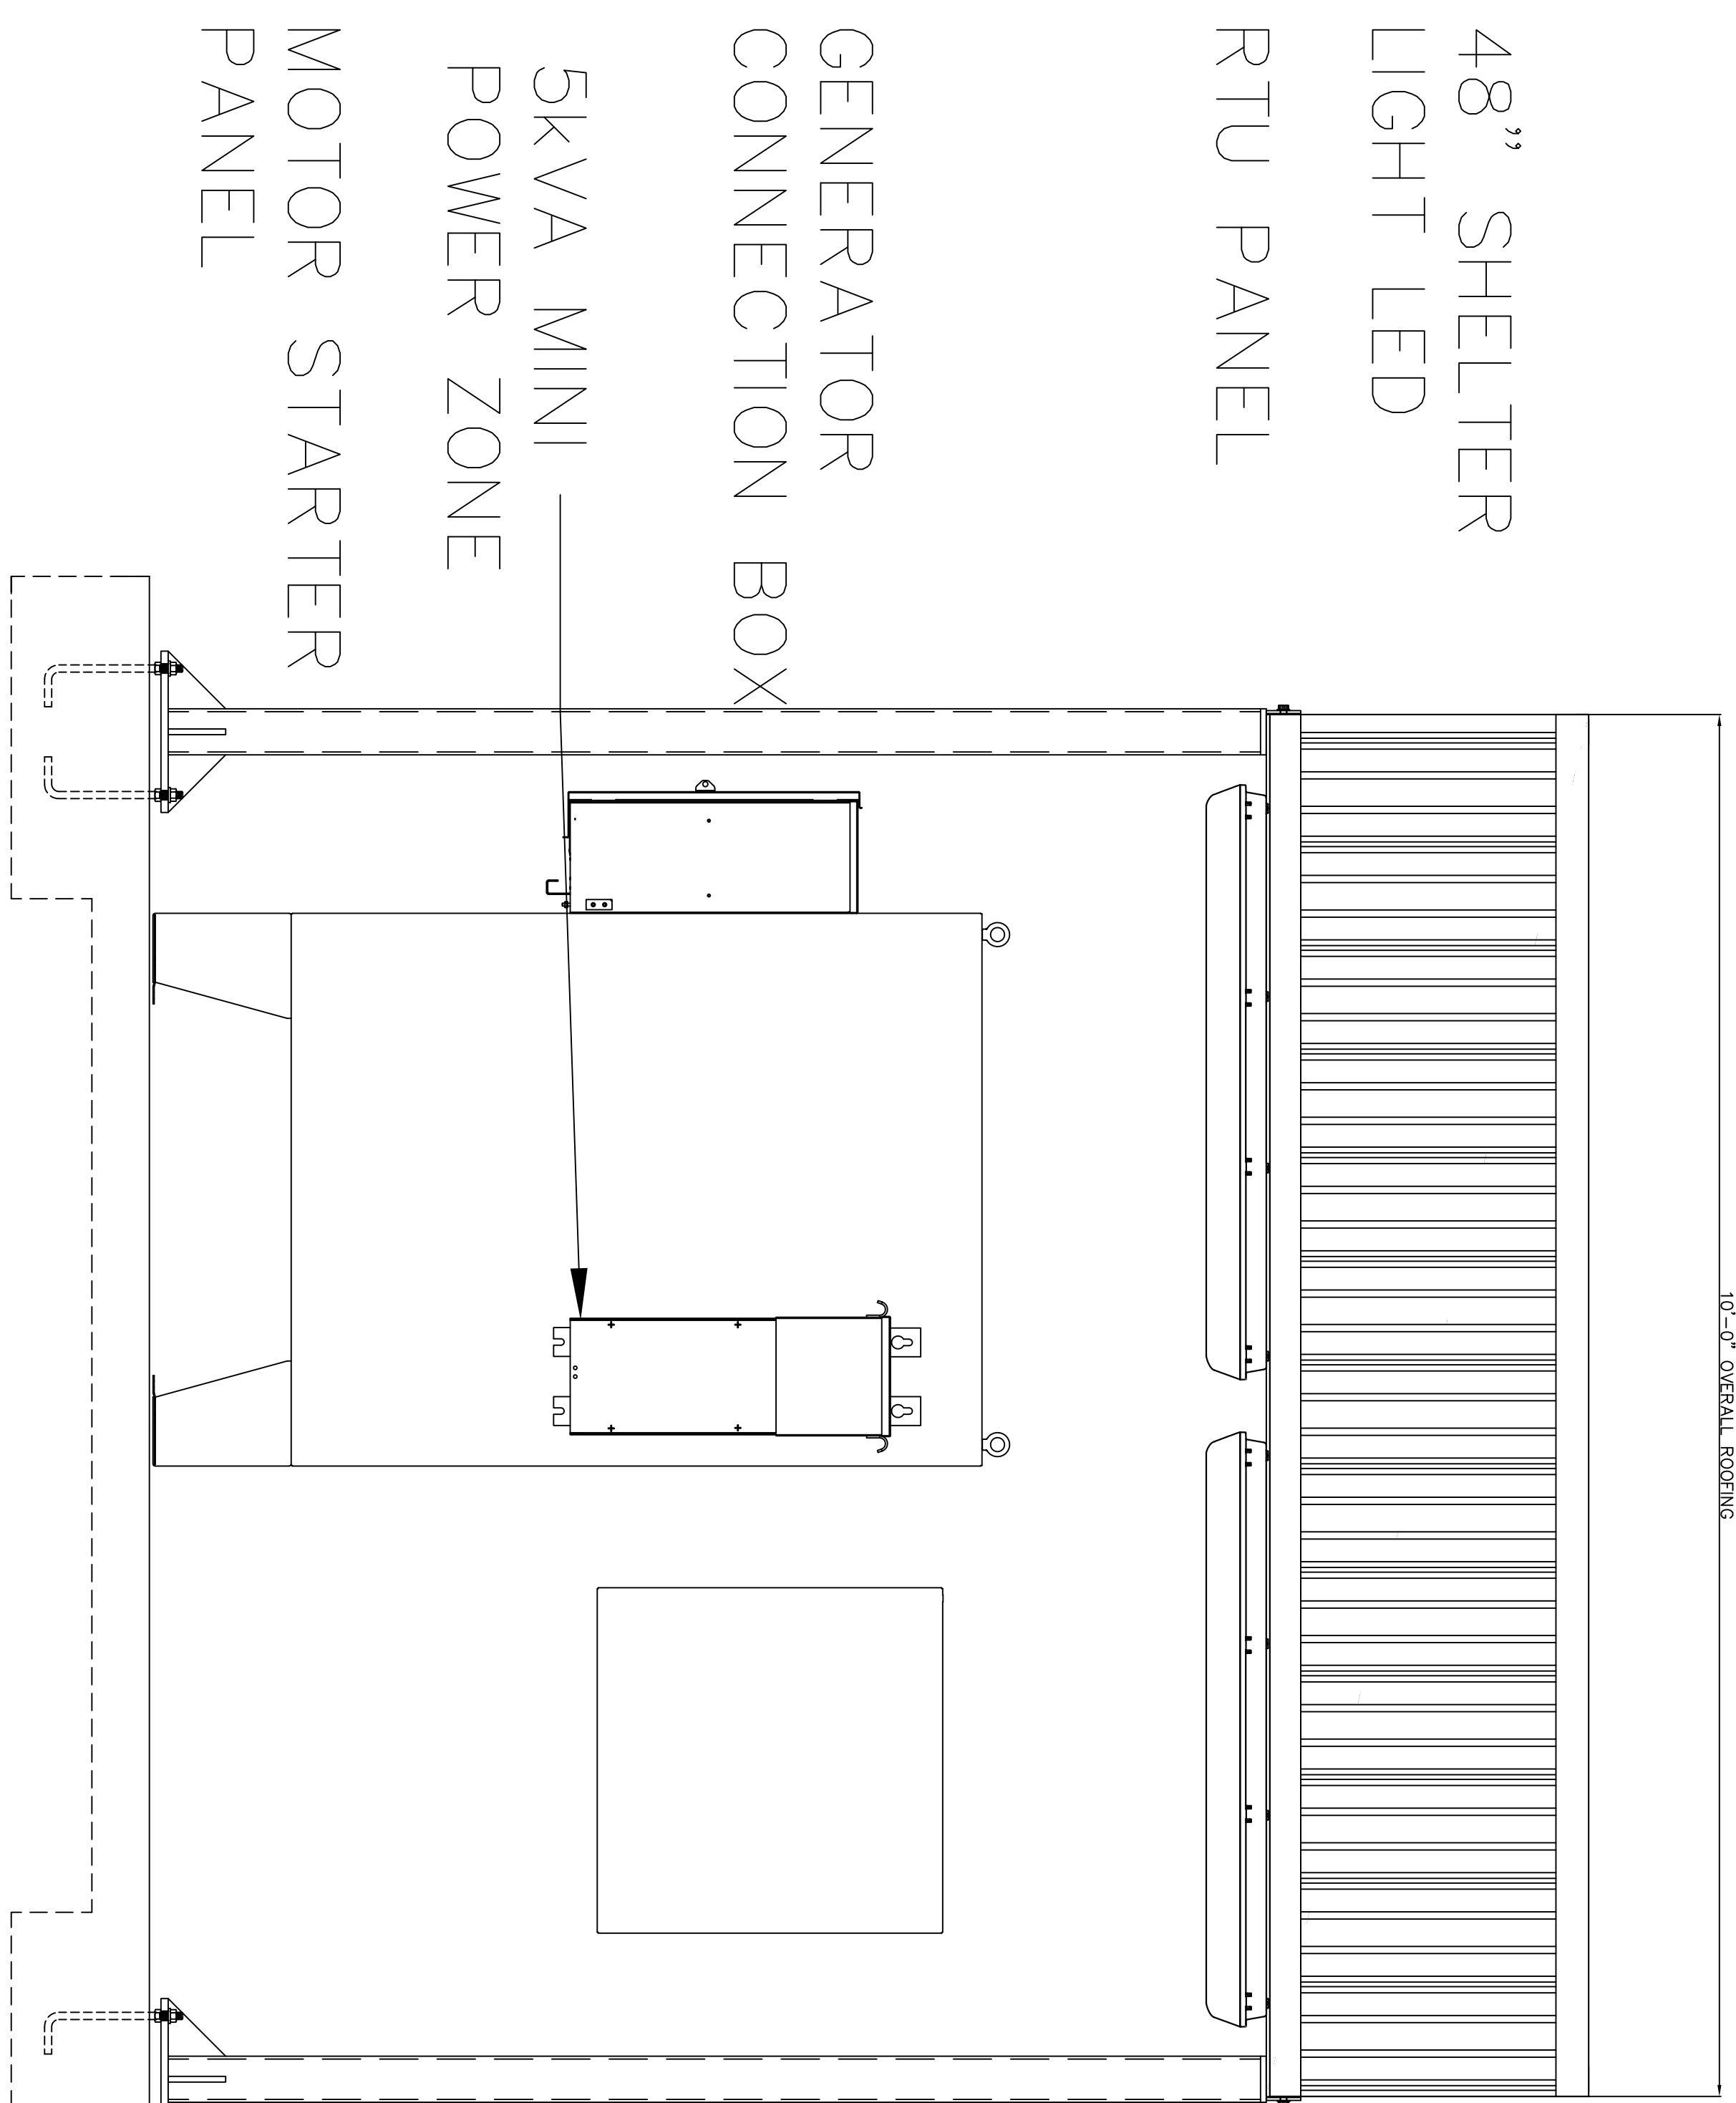

REAR VIEW

48" SHELTER LIGHT LED  
 RTU PANEL  
 GENERATOR CONNECTION BOX  
 5KVA MINI POWER ZONE  
 MOTOR STARTER PANEL

10'-0" OVERALL ROOFING

10'-0" OVERALL ROOFING

KEYED NOTES:  
 1 MOUNT EQUIPMENT TO UNISTRUT RACK

A

ELEVATION VIEW  
 NTS

STRINGFIELD GRANITE MTN SEWER  
 PRESCOTT, AZ  
 SHELTER LAYOUT  
 DUPLEX LIFT STATION

**ROMTEC UTILITIES**  
 18240 NORTH BANK ROAD  
 ROSEBURG, OREGON 97470  
 PHONE: (541) 496-9678  
 WWW.ROMTECUTILITIES.COM

©2022 ROMTEC UTILITIES INC. ALL RIGHTS RESERVED. THESE PLANS AND DRAWINGS MAY NOT BE REPRODUCED, ADAPTED, OR FURTHER DISTRIBUTED, AND NO COMPONENTS MAY BE CONSTRUCTED FROM THESE PLANS, WITHOUT WRITTEN PERMISSION OF ROMTEC UTILITIES, INC.

PROJECT #:	EO106D10	
DSN:	2	2/23/26
DRN:	1	1/9/25
CKD:	REV	DATE
DATE:	12/2/24	

REVISION HISTORY	DESCRIPTION	BY
AS BUILT		JLB
ADDED GROUNDING DETAILS		JLB