


AS BUILT

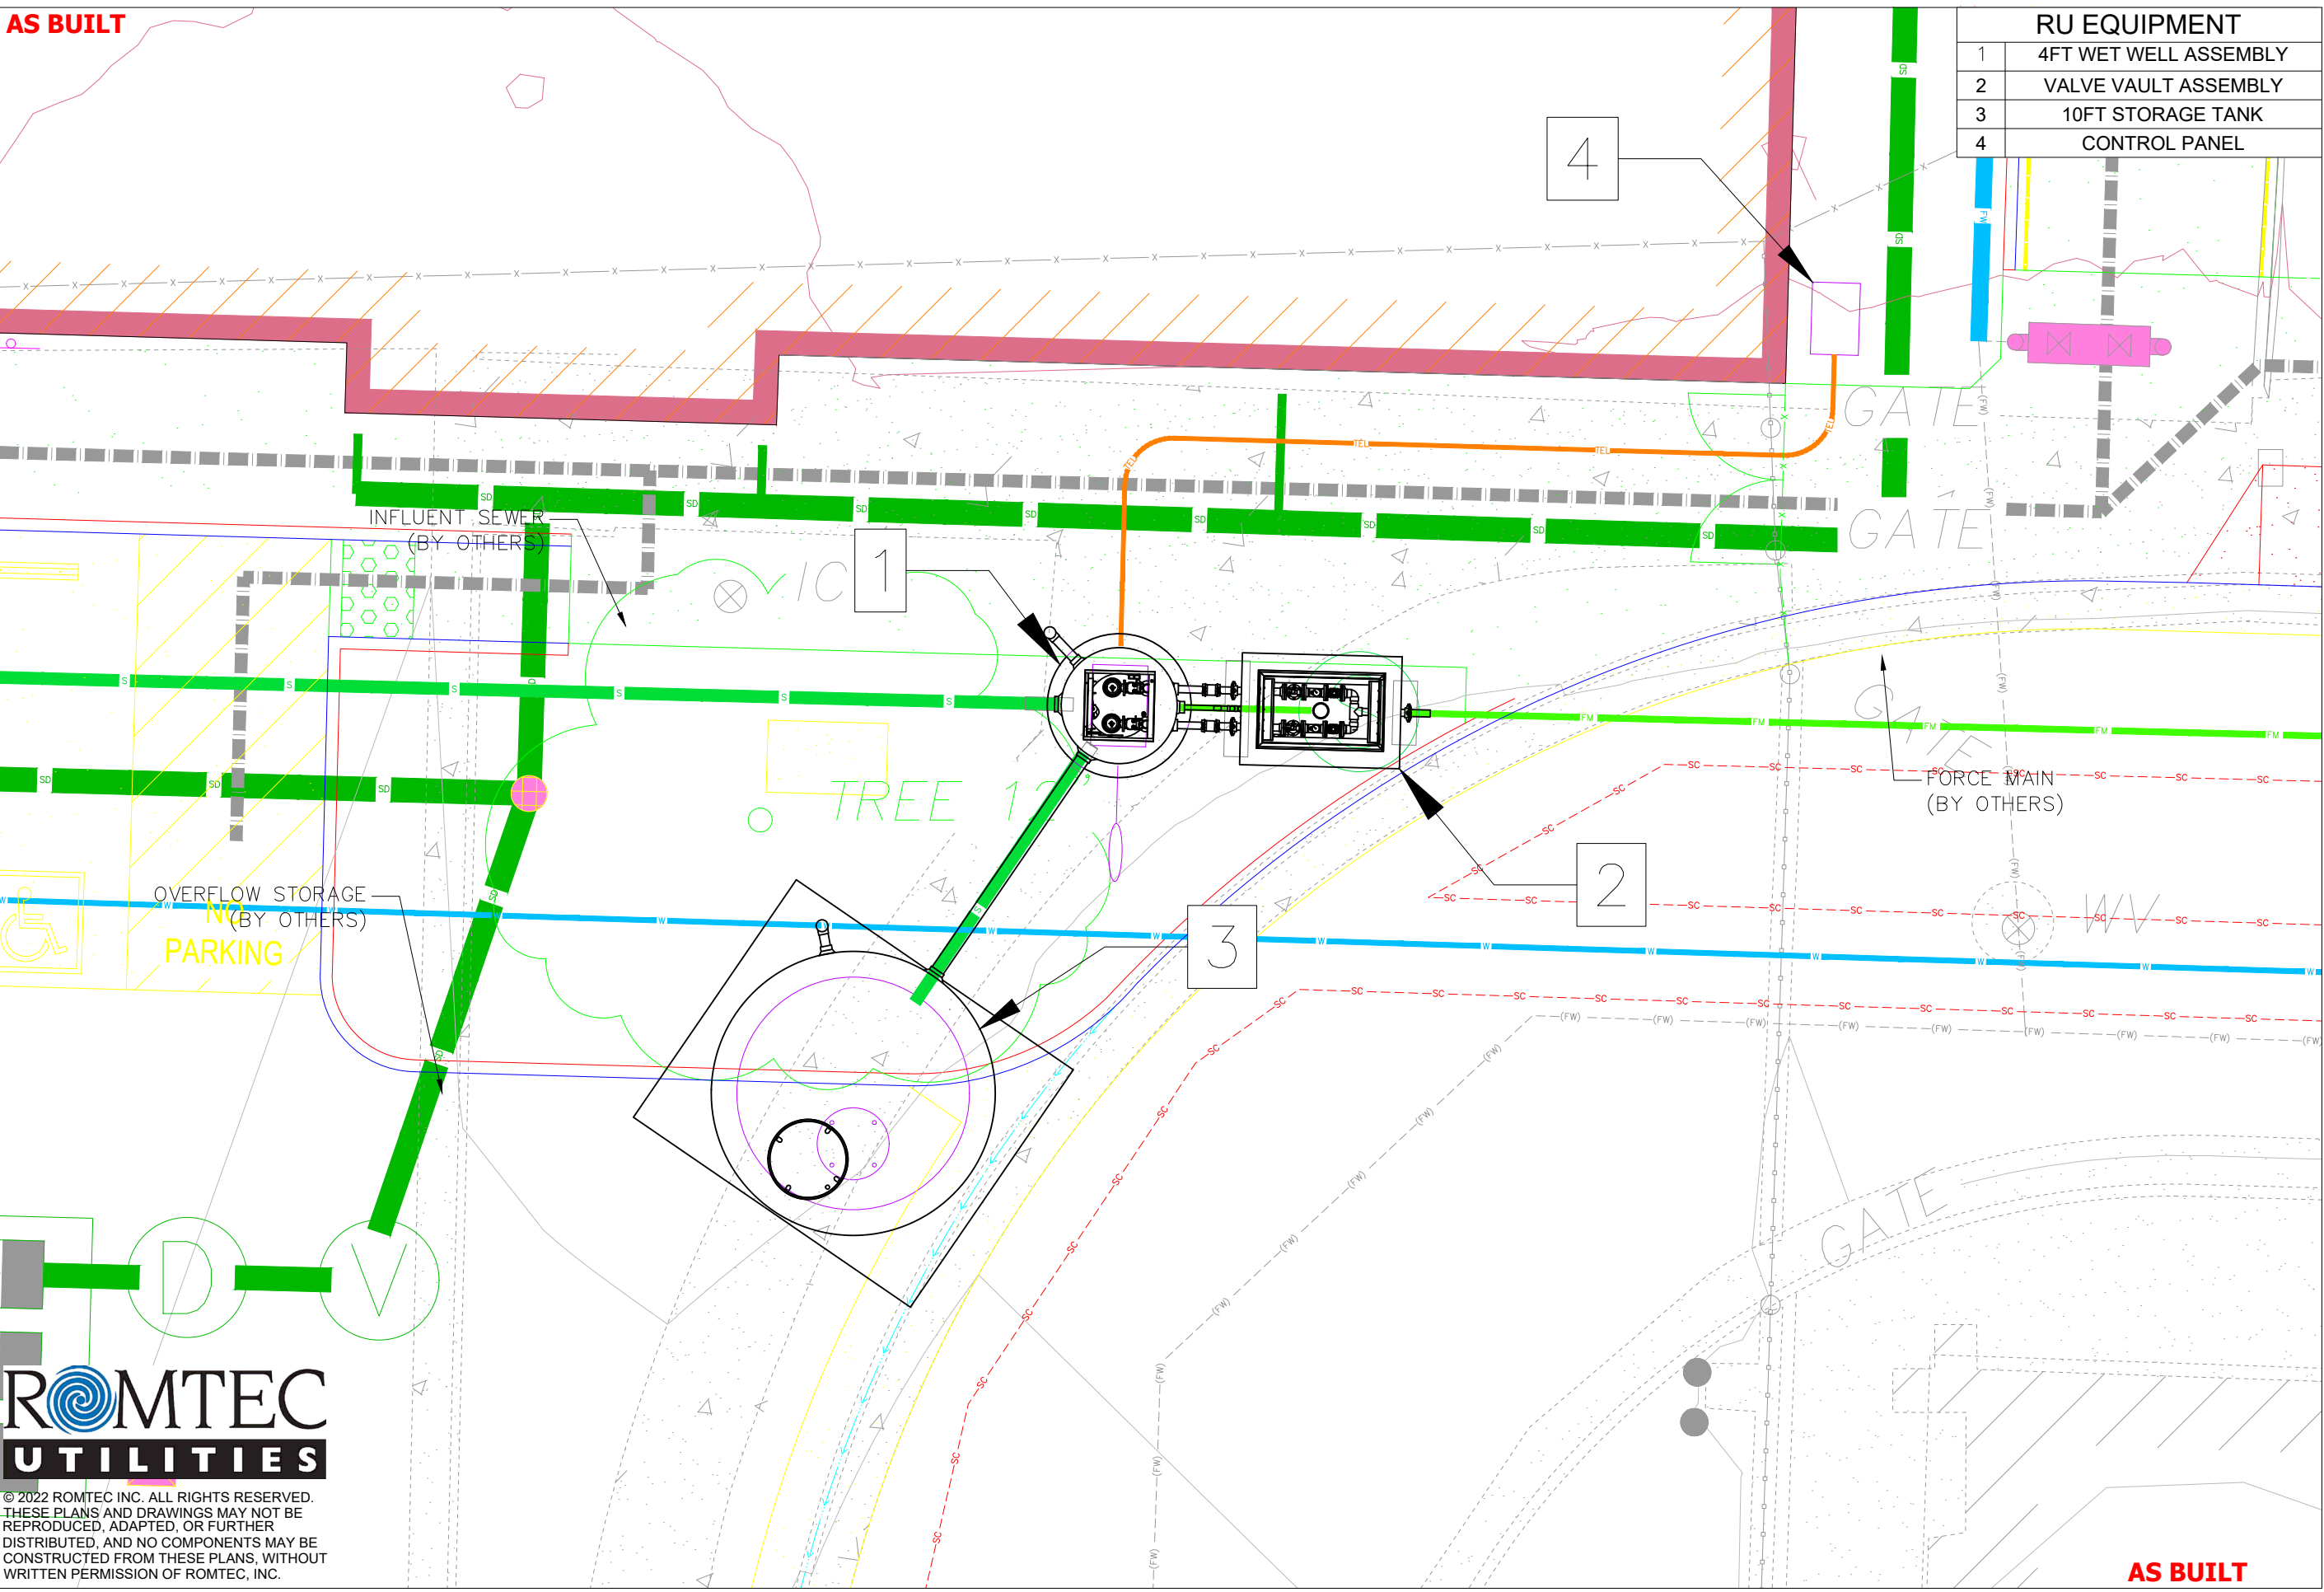

© 2022 ROMTEC INC. ALL RIGHTS RESERVED.
THESE PLANS AND DRAWINGS MAY NOT BE
REPRODUCED, ADAPTED, OR FURTHER
DISTRIBUTED, AND NO COMPONENTS MAY BE
CONSTRUCTED FROM THESE PLANS, WITHOUT
WRITTEN PERMISSION OF ROMTEC, INC.

ROMTEC UTILITIES
18240 NORTH BANK ROAD
ROSEBURG, OREGON 97470
PHONE: (541) 496-9678
WWW.ROMTECUTILITIES.COM

PASO ROBLES HS
PASO ROBLES, CA
WASTEWATER PUMP STATION
PRELIMINARY LAYOUT

SHEET
C-01

REV	DATE	DESCRIPTION
3	6/19/24	STORAGE TANK
2	5/24/24	UPDATED ELEVATIONS & STORAGE CAPACITY
1	10/18/2023	4FT DIA WET WELL
0	8/11/23	INITIAL DESIGN
REV	DATE	DESCRIPTION

RD	BY	REV	DATE	DESCRIPTION
3	6/19/24	STORAGE TANK		
2	5/24/24	UPDATED ELEVATIONS & STORAGE CAPACITY		
1	10/18/2023	4FT DIA WET WELL		
0	8/11/23	INITIAL DESIGN		
REV	DATE	DESCRIPTION		