




DATE LAST PLOTTED: 1/20/2023 12:24 PM PATH AND FILENAME: P:\8900-8999\8975 - PORT ORCHARD, WA - BRIDGE VIEW\ACAD\8975A-001B.DWG

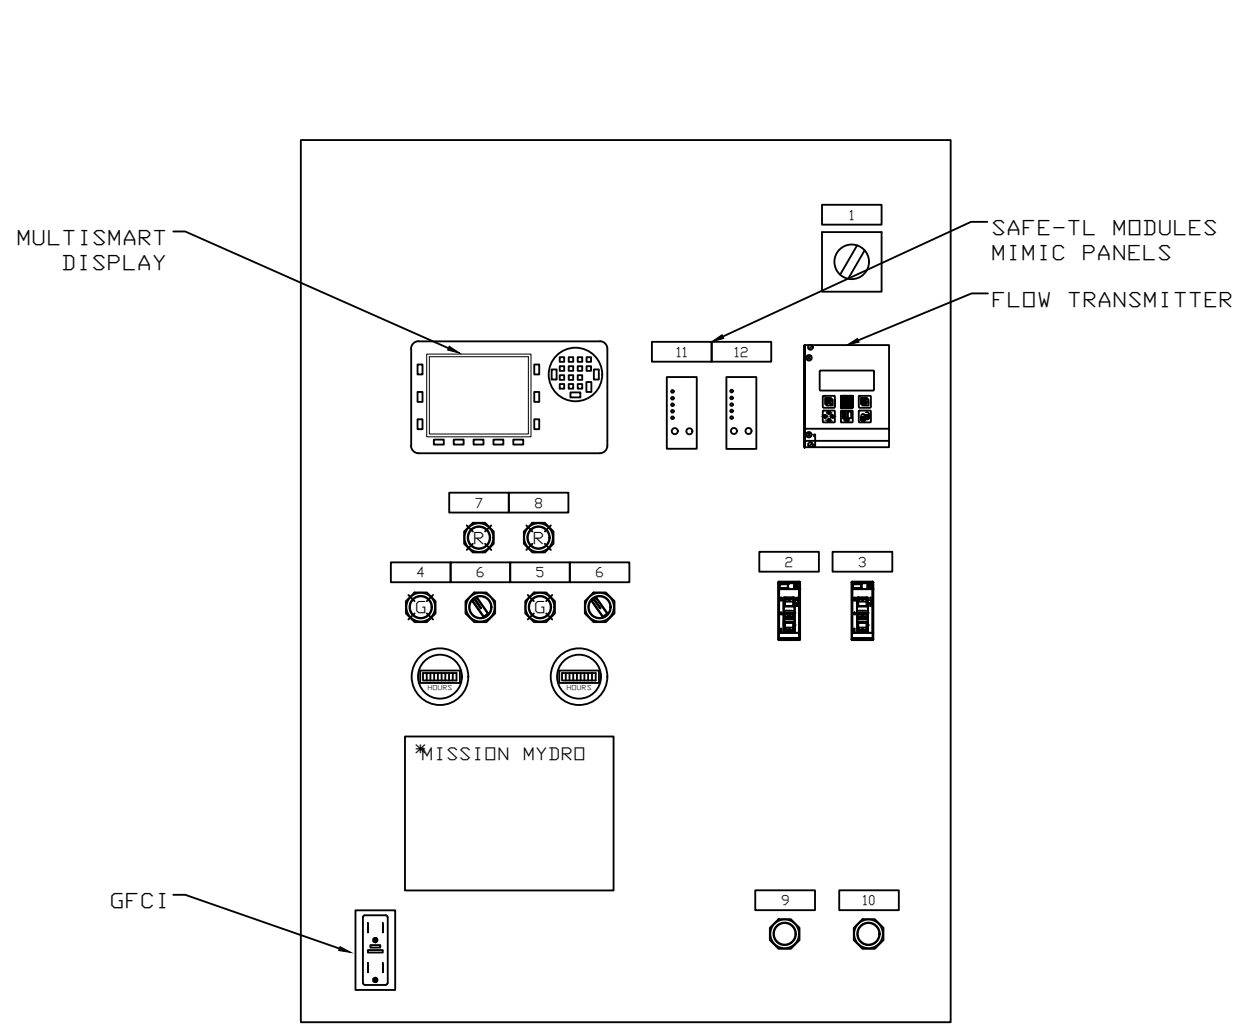

INNER DOOR LAYOUT

NOTES:

1. ENCLOSURE IS A NEMA TYPE 3R HOFFMAN A48H3612SSLP3PT, WITH INNER PANEL HOFFMAN A48P36.
2. FINISH IS BRUSHED STAINLESS STEEL.
3. ENCLOSURE IS INSULATED.
4. INCLUDES ALUMINUM INNER DOOR.
5. UL 508A.

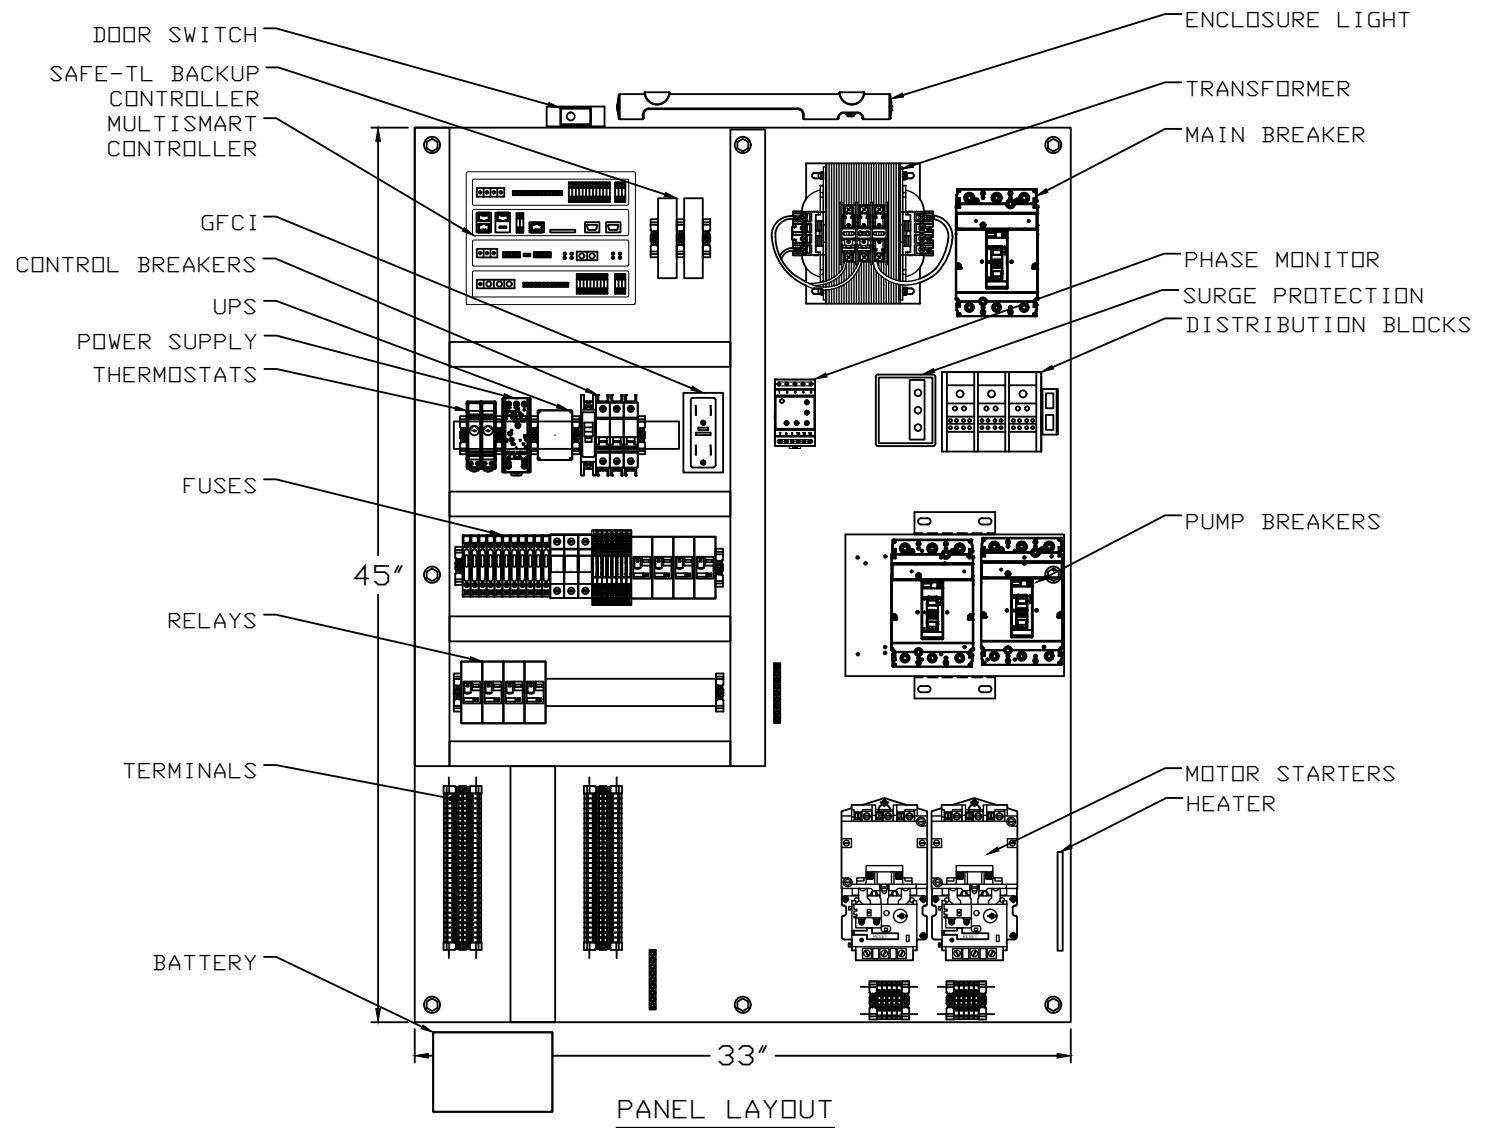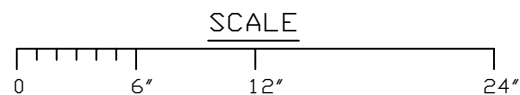

NAMEPLATE SCHEDULE					
NP	DESC1	DESC2	DESC3	SIZE	REMARKS
01	MAIN DISCONNECT			1X3	QTY 1
02	PUMP 1			1X3	QTY 1
03	PUMP 2			1X3	QTY 1
04	PUMP 1	RUNNING		1X3	QTY 1
05	PUMP 2	RUNNING		1X3	QTY 1
06	OFF	HAND AUTO		1X3	QTY 2
07	HIGH LEVEL			1X3	QTY 1
08	LOW LEVEL			1X3	QTY 1
09	PUMP 1	RESET		1X3	QTY 1
10	PUMP 2	RESET		1X3	QTY 1
11	BACKUP CONTROLLER	1		1X3	QTY 1
12	BACKUP CONTROLLER	2		1X3	QTY 1
NAMEPLATES ARE BLACK WITH WHITE LETTERS					

AS BUILT DRAWINGS FINAL DRAWINGS SHOWING ANY CHANGES MADE IN MANUFACTURING 1/16/23	 primexcontrols.com 13005 16th Avenue N - Suite 100 - Plymouth, MN 55441 763-559-0568	DATE	1/16/23	PROJECT		PORT ORCHARD, WA	
		1/16/23		BRIDGE VIEW		PROJ. NO.	8975A
				PANEL LAYOUT		DWG. NO.	001B
		 primexcontrols.com 13005 16th Avenue N - Suite 100 - Plymouth, MN 55441 763-559-0568		THIS DRAWING CONTAINS PROPRIETARY INFORMATION WHICH MUST NOT BE DUPLICATED, USED, OR DISCLOSED IN WHOLE OR IN PART WITHOUT PRIOR WRITTEN CONSENT.		DATE 1/16/23 DWN DKH CKD. ENGR. DKH ASSEM SHEET 4 OF 16	